
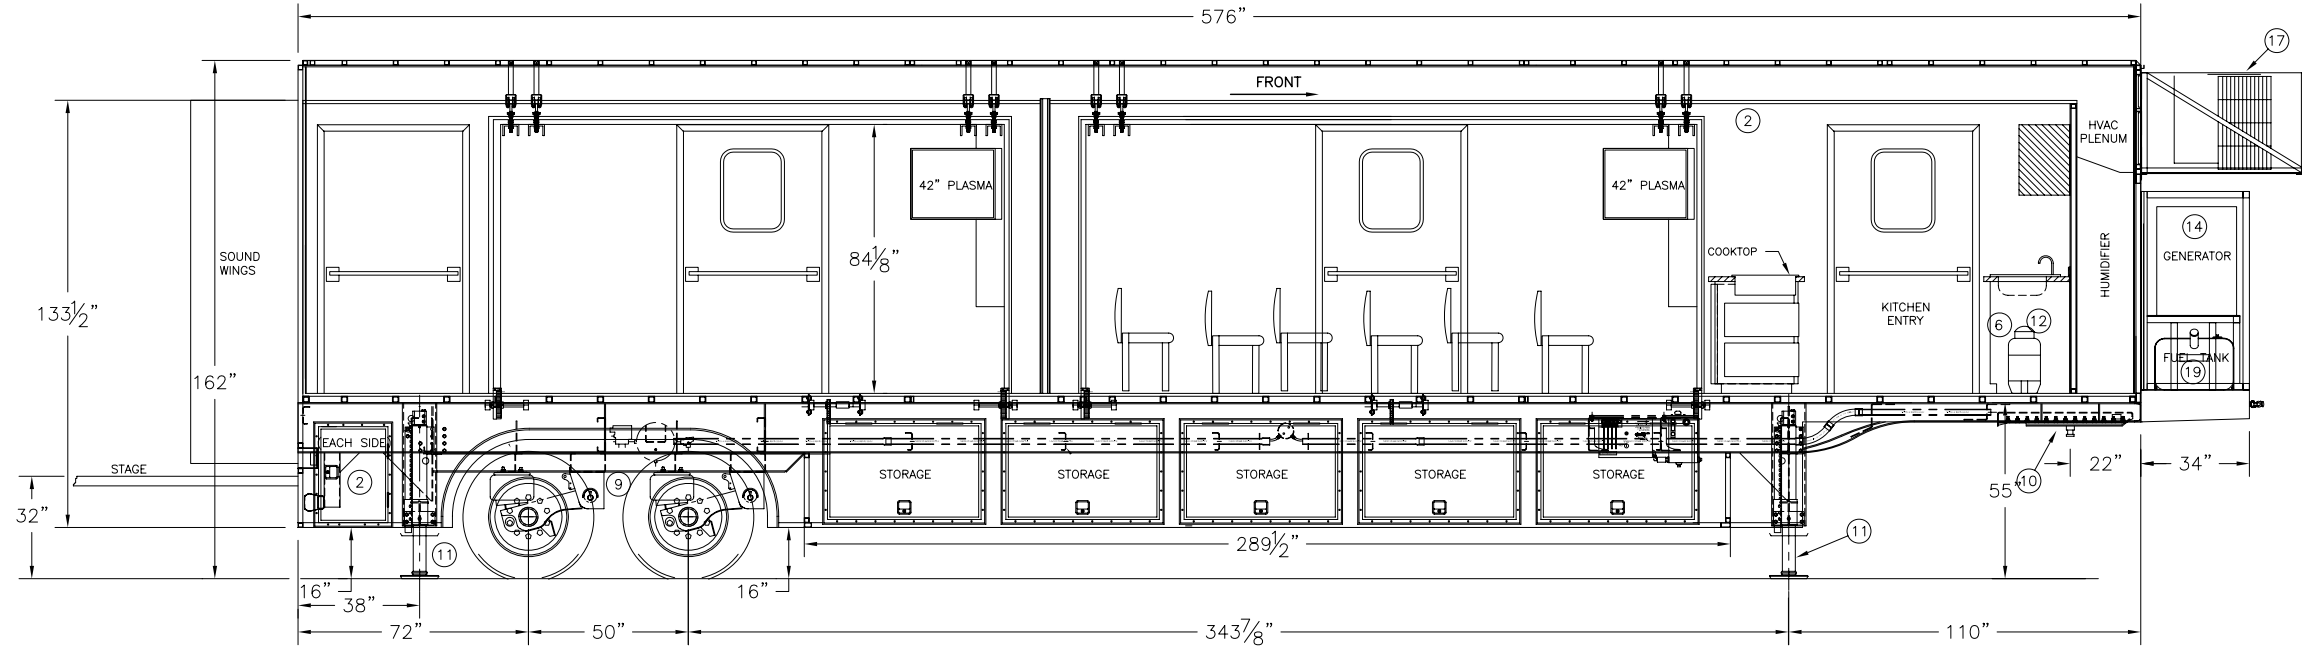


REVISIONS					
REV.	REV. DATE	CHK. BY	CHK. DATE	ENG.	DESCRIPTION
04	16OCT03	DEK	16OCT03	C.H	AS-BUILT

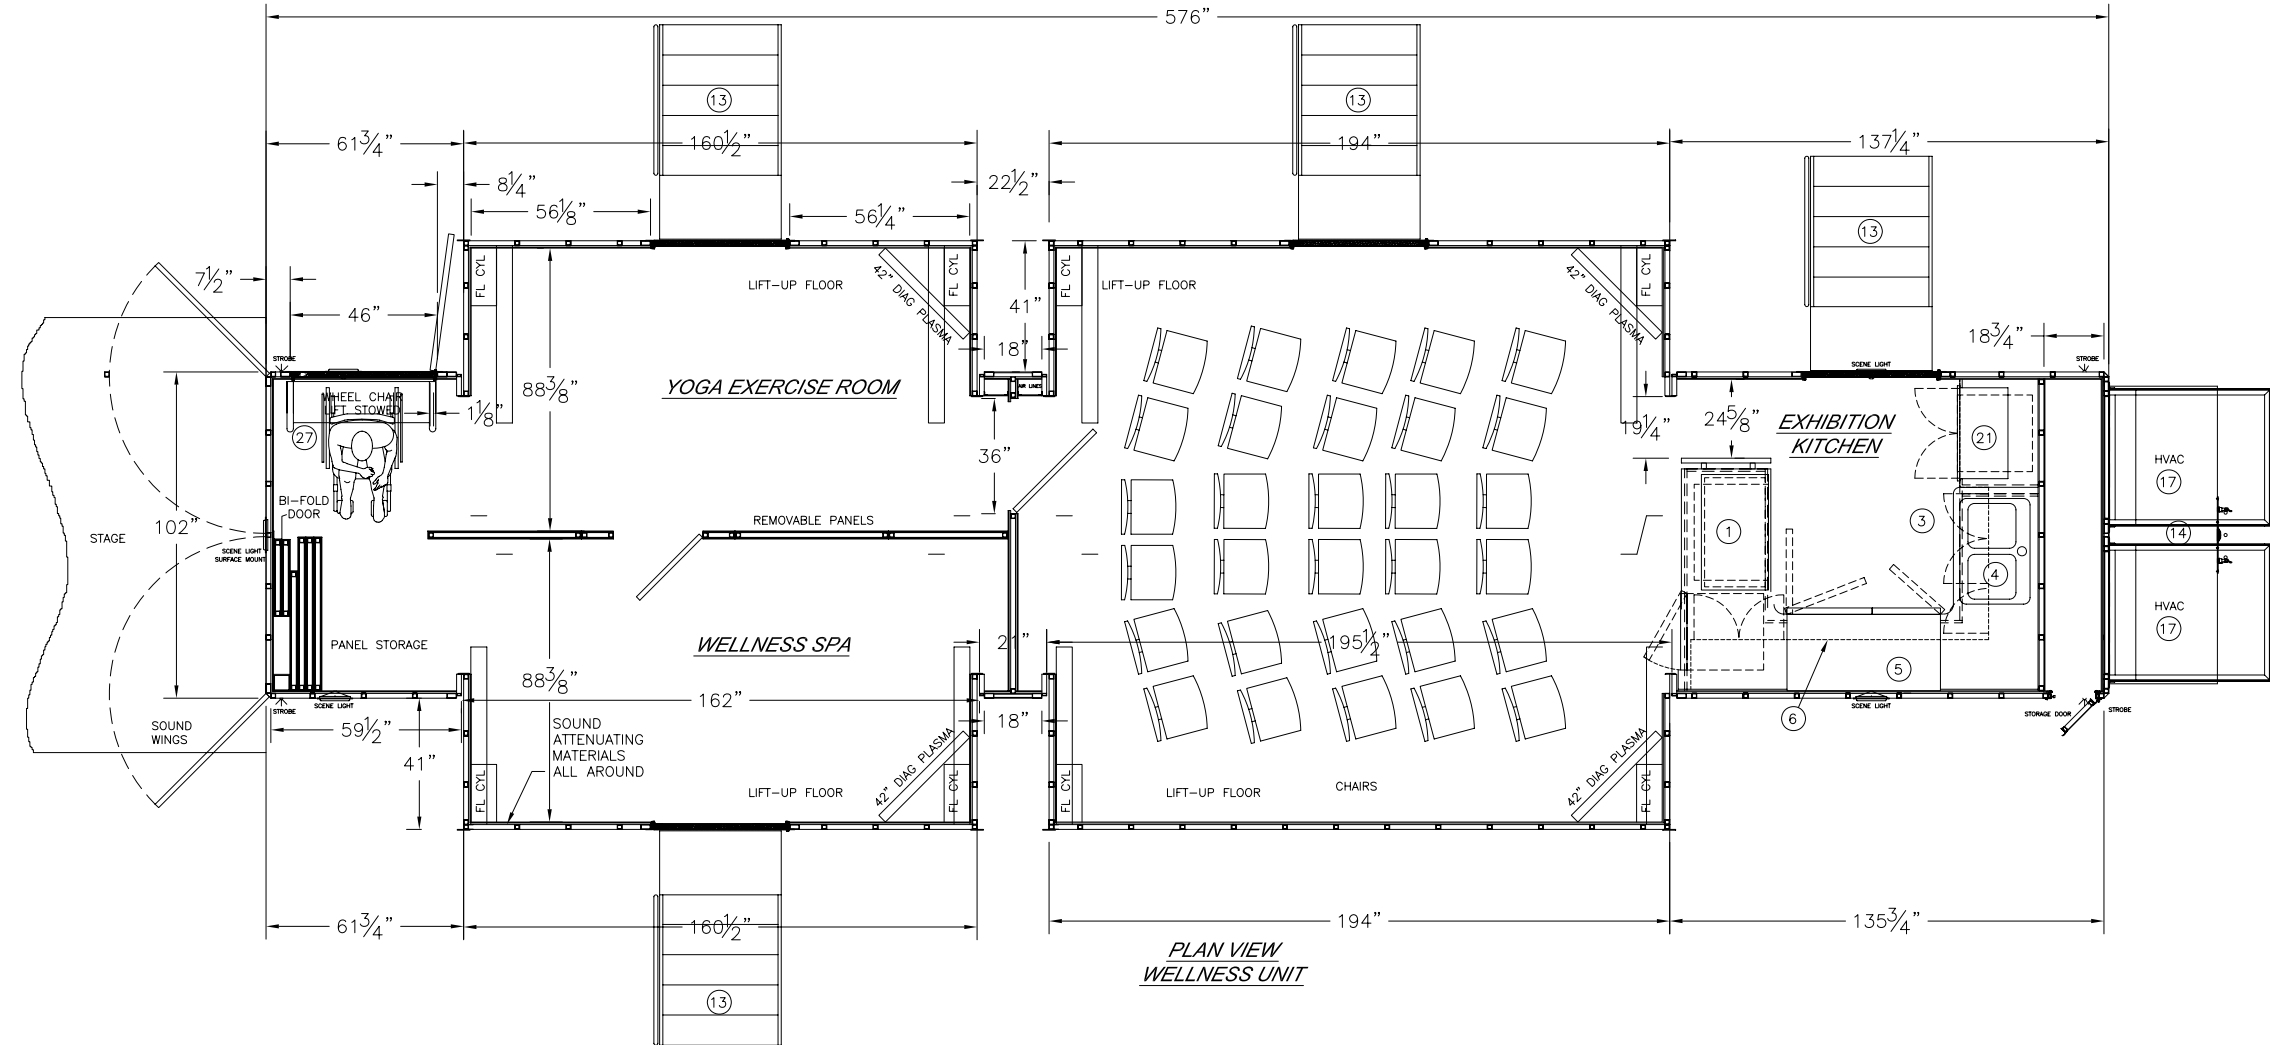

ITEM	QTY	PART NUMBER	DESCRIPTION
21	1		OVEN
20	1		LOAD CENTER - NOT SHOWN
19	1		70 GALLON FUEL TANK
18	2		DUAL SUMP SYSTEMS
17	2		HVAC, 60,000-BTU
16	1		WHEEL CHAIR LIFT
15	TBD		FRESH WATER TANK - NOT SHOWN
14	1		21KW GENERATOR
13	4		STAIR, HANDRAIL, PLATFORM ASSY
12	2		SMART WATER SYSTEM
11	4		HYDRAULIC LEVELING LEGS, 32,000 LB. CAP.
10	1		AIR RIDE UPPER COUPLER (KING PIN)
9	1		AIR RIDE SUSPENSION, 34,000 LB CAP.
8	-		OVERHEAD CABINETS
7	-		CLOSED CIRCUIT TV SYSTEM
6	-		CABINET
5	1		REFRIGERATOR
4	1		SINK
3	1		AUTOMATIC DISHWASHER
2	1		VENT HOOD
1	1		ELECTRIC RANGE

BILL OF MATERIALS

THIS DRAWING IS PROVIDED ON A CONFIDENTIAL BASIS SUBJECT TO RETURN ON DEMAND OF OSHKOSH SPECIALTY VEHICLES ("OSHKOSH"), WHICH RETAINS ANY AND ALL RIGHTS ASSOCIATED WITH IT AND THE ARTICLE OR ARTICLES IT REPRESENTS. DISCLOSURE, REPRODUCTION OR ALTERATION OF ANY PART OF THIS DRAWING; OR MANUFACTURE, USE OR SALE OF THE ARTICLE OR ARTICLES REPRESENTED, IS PROHIBITED WITHOUT THE PRIOR WRITTEN AUTHORIZATION OF OSHKOSH. © OSHKOSH SPECIALTY VEHICLES (unpublished).

CUSTOMER AUTHORIZATION

COMPANY NAME: _____

NAME (PRINT): _____ TITLE: _____

SIGNATURE: _____ DATE: _____

SHEET NUMBER: 1 OF 3

JOB# _____

REFERENCE DRAWING: _____

TITLE: GENERAL LAYOUT DRAWING MOVING EXPERIENCES WELLNESS UNIT 8'-6" X 13'-6" X 48'-0" TRAILER

DATE: 21JAN03

SCALE: 3/8"=1'-0"

DRAWN BY: DEK

CHECKED BY: _____

DRAWING NUMBER: 10241-A01

OSHKOSH SPECIALTY VEHICLES

16745 S. LATHROP AVENUE
HARVEY, IL, 60426
PHONE: (708) 596-5066
FAX: (708) 596-2480